


1017 PLACE CONDORINS
UNIT #1-A-B
1017 TURNPIKE STREET
CAMDEN, MASSACHUSETTS 01921.

EXHIBIT "A"
SHEET NUMBER 1 OF 1
UNIT NUMBER 2-A-B

THIS UNIT IS UNIT #2-A-B, ITS POST OFFICE ADDRESS IS SUITE 2-A-B, 1017 TURNPIKE STREET, CAMDEN, MA 01921. I HEREBY CERTIFY THAT THIS PLAN WAS PREPARED IN CONFORMITY WITH THE RULES AND REGULATIONS OF THE REGISTER OF DEEDS OF THE COMMONWEALTH OF MASSACHUSETTS.

I HEREBY CERTIFY THAT THIS PLAN SHOWS THE UNIT DESIGNATED UNIT #2-A-B OF THE 1017 PLACE CONDORINS, AND THE DESIGNATION OF THE UNIT BUILDING UNIT, AND I FURTHER CERTIFY THAT THIS PLAN FULLY AND CORRECTLY SETS FORTH THE LOCATION AND UNIT NUMBER, DIMENSIONS, APPOINTMENTS, AND IMMEDIATE COMMON AREA TO WHICH IT HAS ACCESS, AS NOTED.

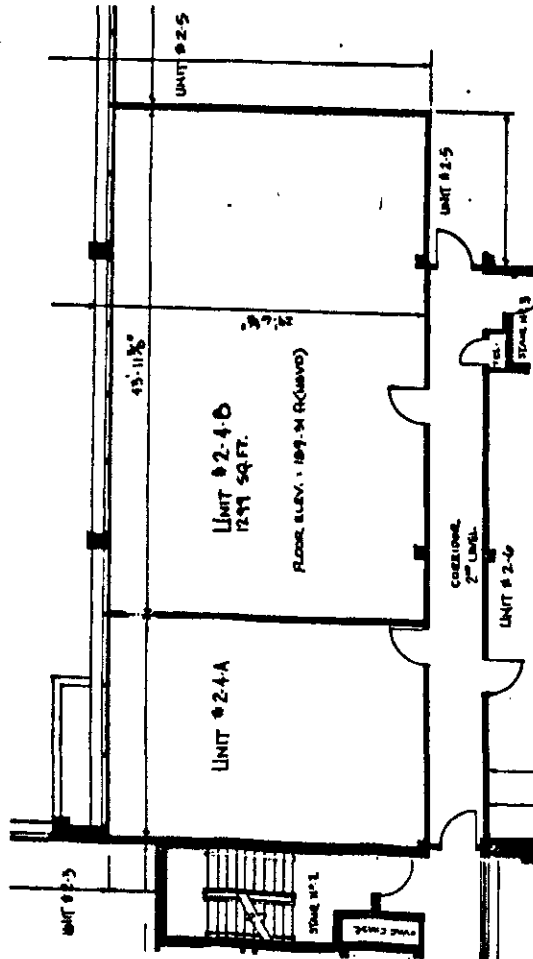

DATE 5-16-86


SIGNATURE

1211 PLACE CONDOMINIUMS
UNIT # 2-5
2011 TURNPIKE STREET
CAMDEN, MASSACHUSETTS 02021

EXHIBIT "A"
SHEET NUMBER 1 OF 1
UNIT NUMBER 2-5

THIS UNIT IS UNIT # 2-5. ITS POST OFFICE ADDRESS IS UNIT # 5
1211 TURNPIKE STREET, CAMDEN, MA 02021. I HEREBY CERTIFY
THAT THIS PLAN WAS PREPARED IN CONFORMITY WITH THE RULES AND
REGULATIONS OF THE REGISTERS OF DEEDS OF THE COMMONWEALTH OF
MASSACHUSETTS.

I HEREBY CERTIFY THAT THIS PLAN SHOWS THE UNIT DESIGNATED
UNIT # 2-5 OF THE 1211 PLACE CONDOMINIUMS, AND THE LOCATION
OF THE IMMEDIATE ADJOINING UNITS, AND THE LOCATION OF THE
THIS PLAN FULLY AND ACCURATELY DEPICTS THE LAYOUT, LOCATIONS
AND UNIT DIMENSIONS, DIMENSIONS, APPROXIMATE AREA, AND IMMEDIATE
COMMON AREA TO WHICH IT HAS ACCESS, AS BUILT.

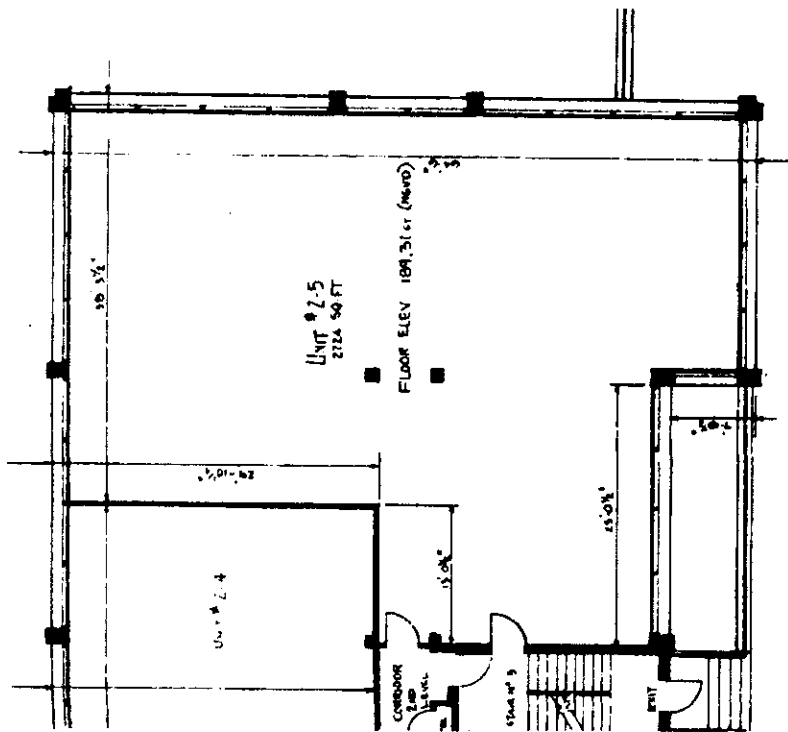

DATE: JUNE 25, 1986

SIGNATURE